

# Borough of Hamilton.

2108-A

## Application for Permit for Sanitary Work by Licensed Sanitary Drainer or Licensed Sanitary Plumber.

### TO ACCOMPANY PLAN OF DRAINAGE.

To the Hamilton Borough Council,

I, the undersigned hereby apply for a permit under the provisions of "The Hamilton Borough By-law No. 2," to carry out the following work:—

Length of Drainage 134 No. of Gullies 2 No. of Inspections 5

Length of Bath Waste and size 4

Length of Basin Waste and size 4

Length of Sink Waste and size 4

Length of Tub Waste and size 8

If Waste Back Vented, give size and length

Other Works: W.C. & S.V.

Value of work.—Plumbing £ 14 : 0 : 0 Drainlaying £ 20 : 0 : 0

In accordance with the accompanying plans and particulars, on the premises situated in

Irvine Street

Lot 78 of Section DP 7510

Name and Address of Licensed Sanitary Drainer J. Merriman

Name and Address of Licensed Sanitary Plumber W. Dick

Name and Address of Owner of Premises J. Twiddle

Dated this 1st day of July 1927

(Signature of Applicant) J. Merriman

Hamilton Borough Council.

SANITARY INSPECTOR'S OFFICE.  
HOUSE CONNECTION PLAN.

No. 2108 A.


Date 1st July 1927

SCALE: 1/8 IN. TO A FOOT.

NEW SEWAGE DRAINS: RED.

STORM WATER: DOTTED BLACK.

OLD DRAINS: FULL BLACK.

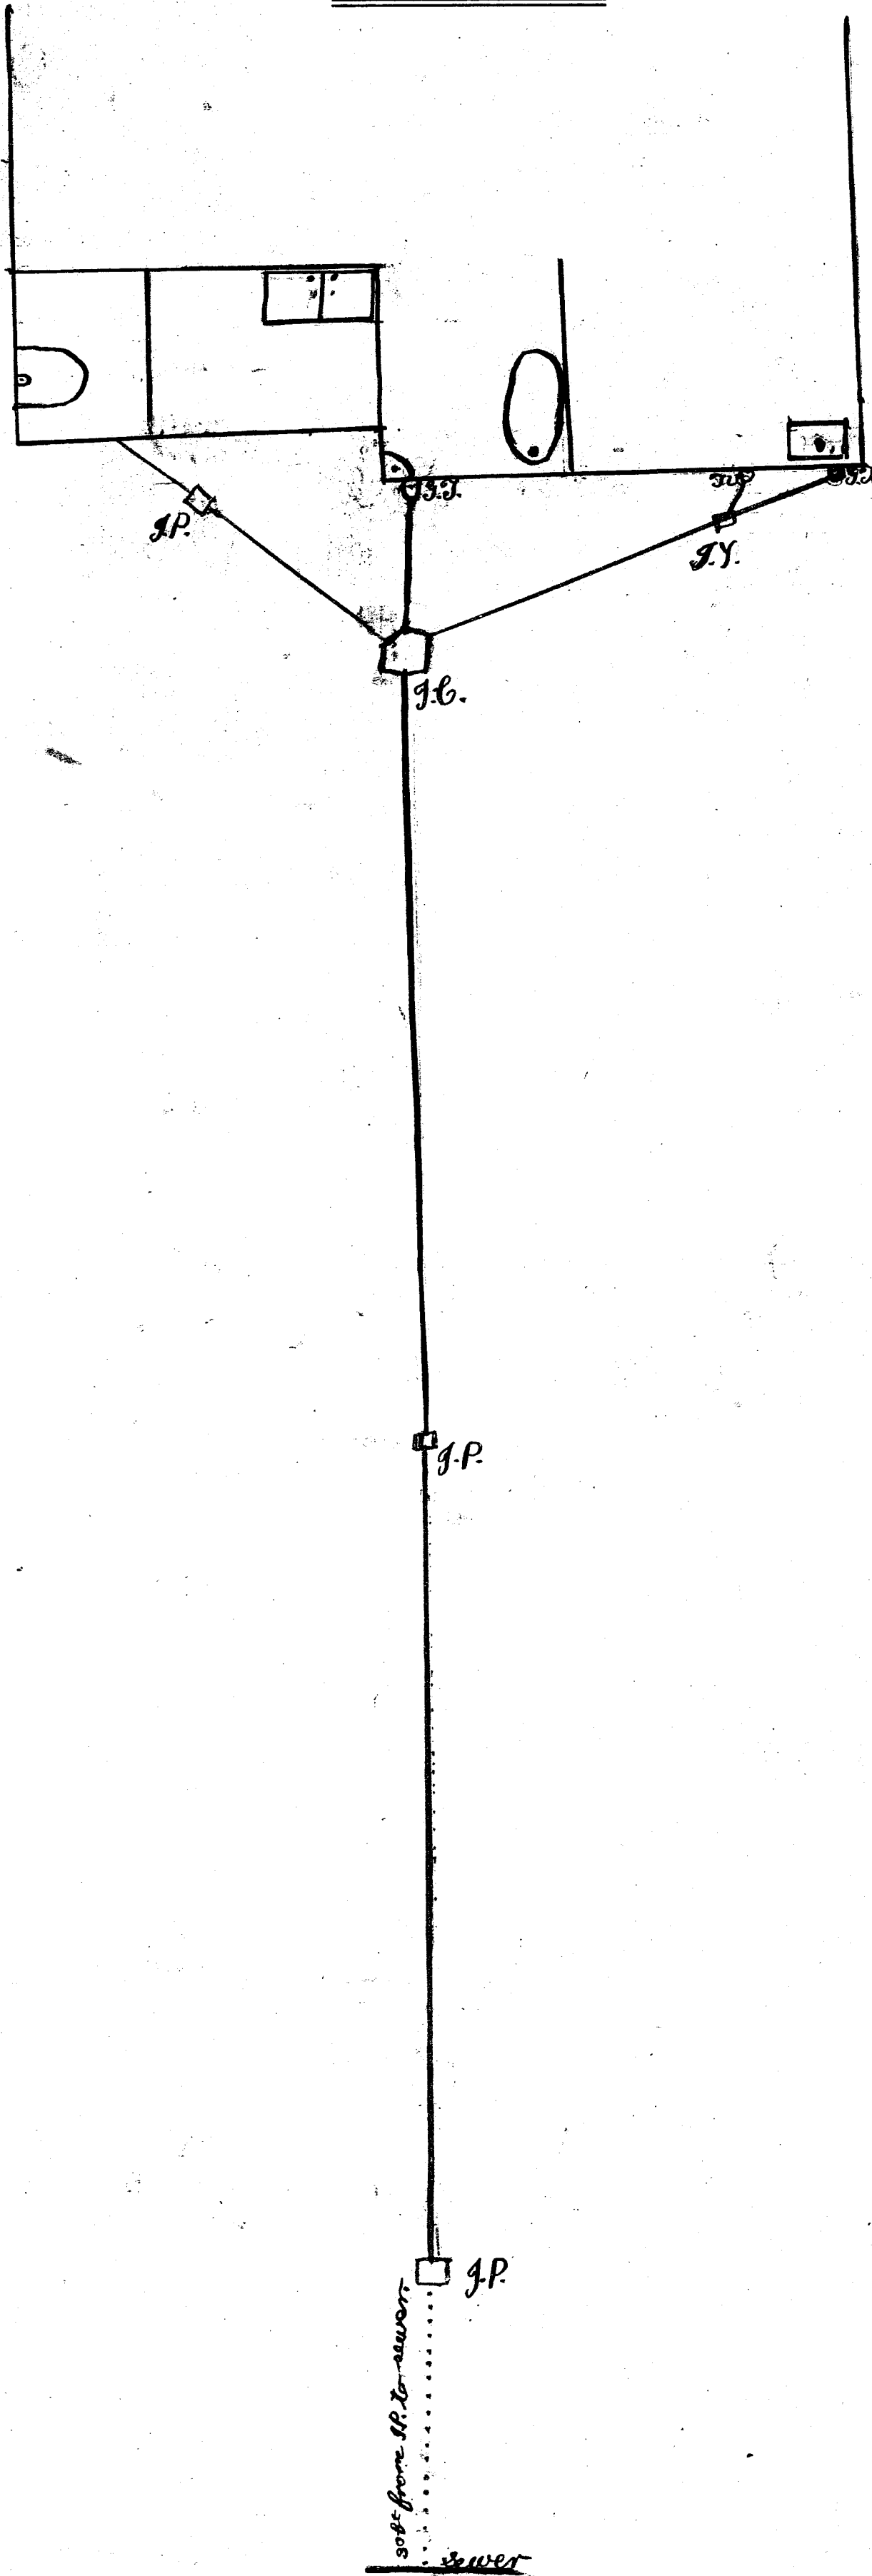

Binding Margin to be left blank.

Tested  
4/7/27  
J.W.S.

Owner J. Twidle.

Section 78.

Street Irvine.

Allotment DP 7570.

Signature of Drainer or Plumber H. Dick Drainer J. Merriman Drainer

As Laid

OFFICE OF THE CHIEF BUILDING INSPECTOR,  
BARTON STREET,  
PRIVATE BAG, HAMILTON, N.Z.  
PHONE 81-919



# HAMILTON CITY

RECEIVED  
- 8 OCT 1985  
BLDG. DIV.

## APPLICATION FOR PERMIT FOR SANITARY, PLUMBING AND DRAINAGE WORK

I, the undersigned (name in full) PETER BROWN address 177 ELICOTTSD RD. HAMILTON.

Hereby make application for permission to carry out the work prescribed herein, as set out in the plans attached hereto, at the premises situated in

29 Ivone Street/Road, being Lot 78 D.P.S. 7510

Name and Address of owner of premises: G. Magner

Nature of Work Divert sewer & New Unit (1)

Value of proposed work excluding materials \$ c

(a) Plumbing \$ 200-00

(b) Drainage (including stormwater) \$ 1300-00

03587 Regd. No. Brown Licensed Plumber

05214 Regd. No. Bill Tait Licensed Drainlayer

Dated this \_\_\_\_\_ day of \_\_\_\_\_ 19\_\_\_\_

Building Permit 67240 (3.10.85) Drainage Permit 025425 Plumbing Permit 025424



Plumbing & Drainage Costs 1200 Plumbing & Drainage Fees 85

Details of drainage and boundaries required overleaf.

RECEIVED  
15 OCT 1985  
BLDG. DIV.

*Issue Grants*  
*MA*

STREET .....

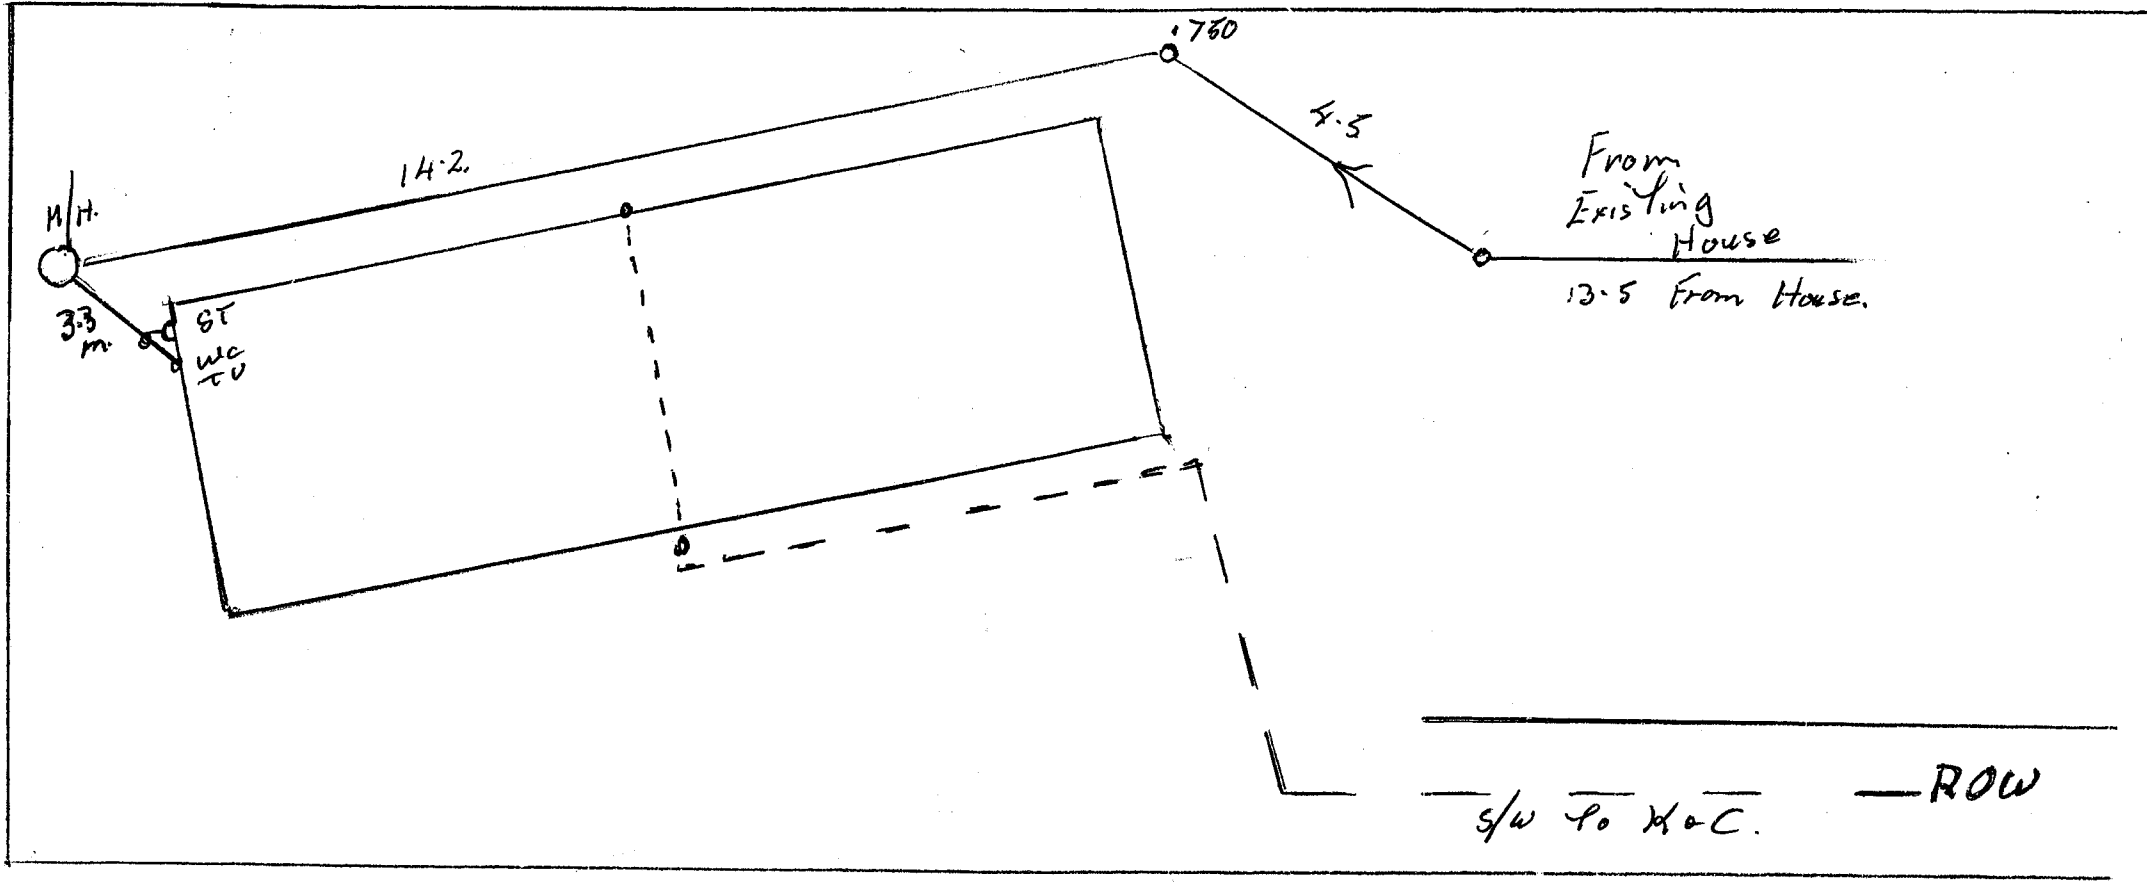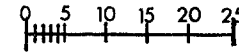

Date of Inspection 29.11.85 *DCR*

Drainlayer's Signature .....